




PROFILE

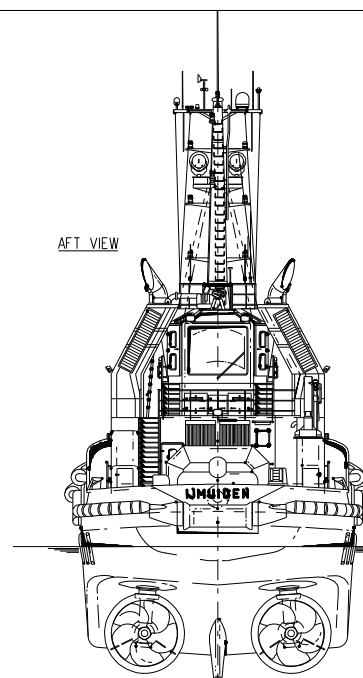


AFT VIEW

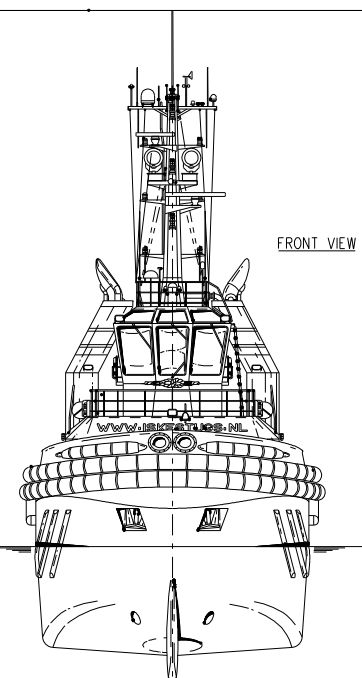


FRONT VIEW

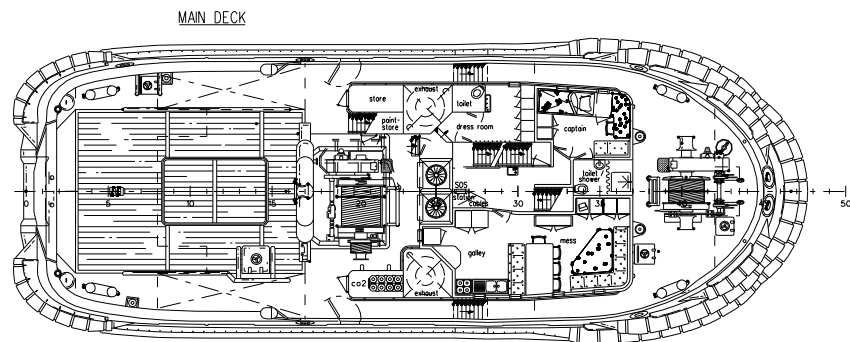


MAIN DECK

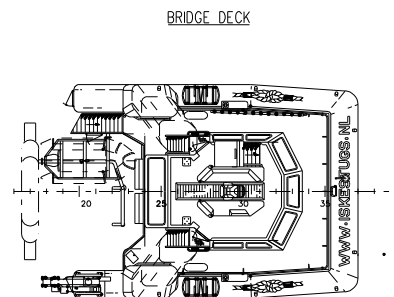

BRIDGE DECK

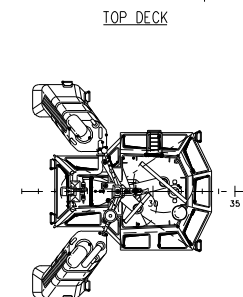

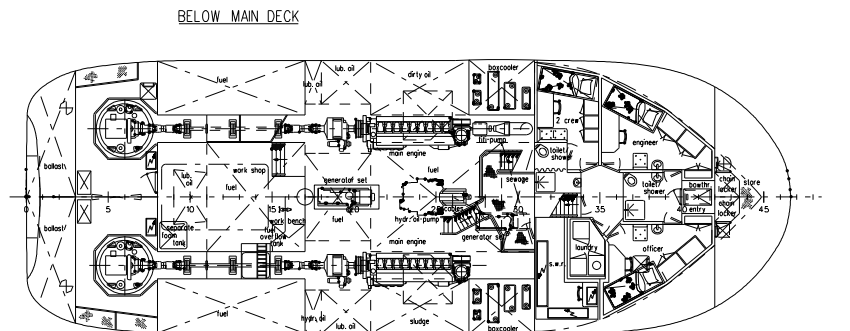

TOP DECK



BELOW MAIN DECK

PRINCIPAL DIMENSIONS	
LENGTH O.A.	29.08 M
LENGTH W.L.	27.21 M
BREADTH MLD.	10.0 M
DEPTH AT SIDE	5.10 M
DRAUGHT	4.57 M

08-03	08-2002	DATE	 DELTA SHIPYARD THE WORKBOAT COMPANY P.O. BOX 81, 3200 AB SLEEDRECHT - HOLLAND TEL: (+31) 0184 435501 FAX: (+31) 0184 435502 EMAIL: info@deltashipyard.nl		 DESTINATION yn.989 M.V.C.NR. 0338-005 IND.NR./SUB NR. 0338-005 DRAW.FROM											
As Built several changes A several changes MOD DESCRIPTION			Copyright of IHC Delta Shipyard, whose property this document remains. No part thereof may be disclosed, copied, duplicated or in any other way made use of except with the written approval of IHC Delta Shipyard.													
			GENERAL ARRANGEMENT DELTA AZIMUTH TUG 2800													
			SCALE 1:100		DATE	DRAWN UM										
F	B	A	NUMBER OF SHEETS 1		SHEET NR. 1	1/A1										
			DRAWING NR. 989-0338-005													
			<table><tr><td>X</td><td>X</td><td>X</td><td>X</td><td>X</td><td>F</td><td></td><td></td><td></td><td></td></tr></table>		X	X	X	X	X	F						
X	X	X	X	X	F											
PLOT DATE :			CAD FILE : 0:/tekening/DAT2800/989/0338_005F													