



BRIDGE DECK


PRINCIPAL DIMENSIONS
L.O.A.....Approx. 66.00 m
L.P.P..... 56.40 m
B. MLD..... 14.60 m
DEPTH M-deck.. Approx. 7.40 m
DRAFT max..... Approx. 6.30 m
DRAFT design..... Approx. 5.20 m

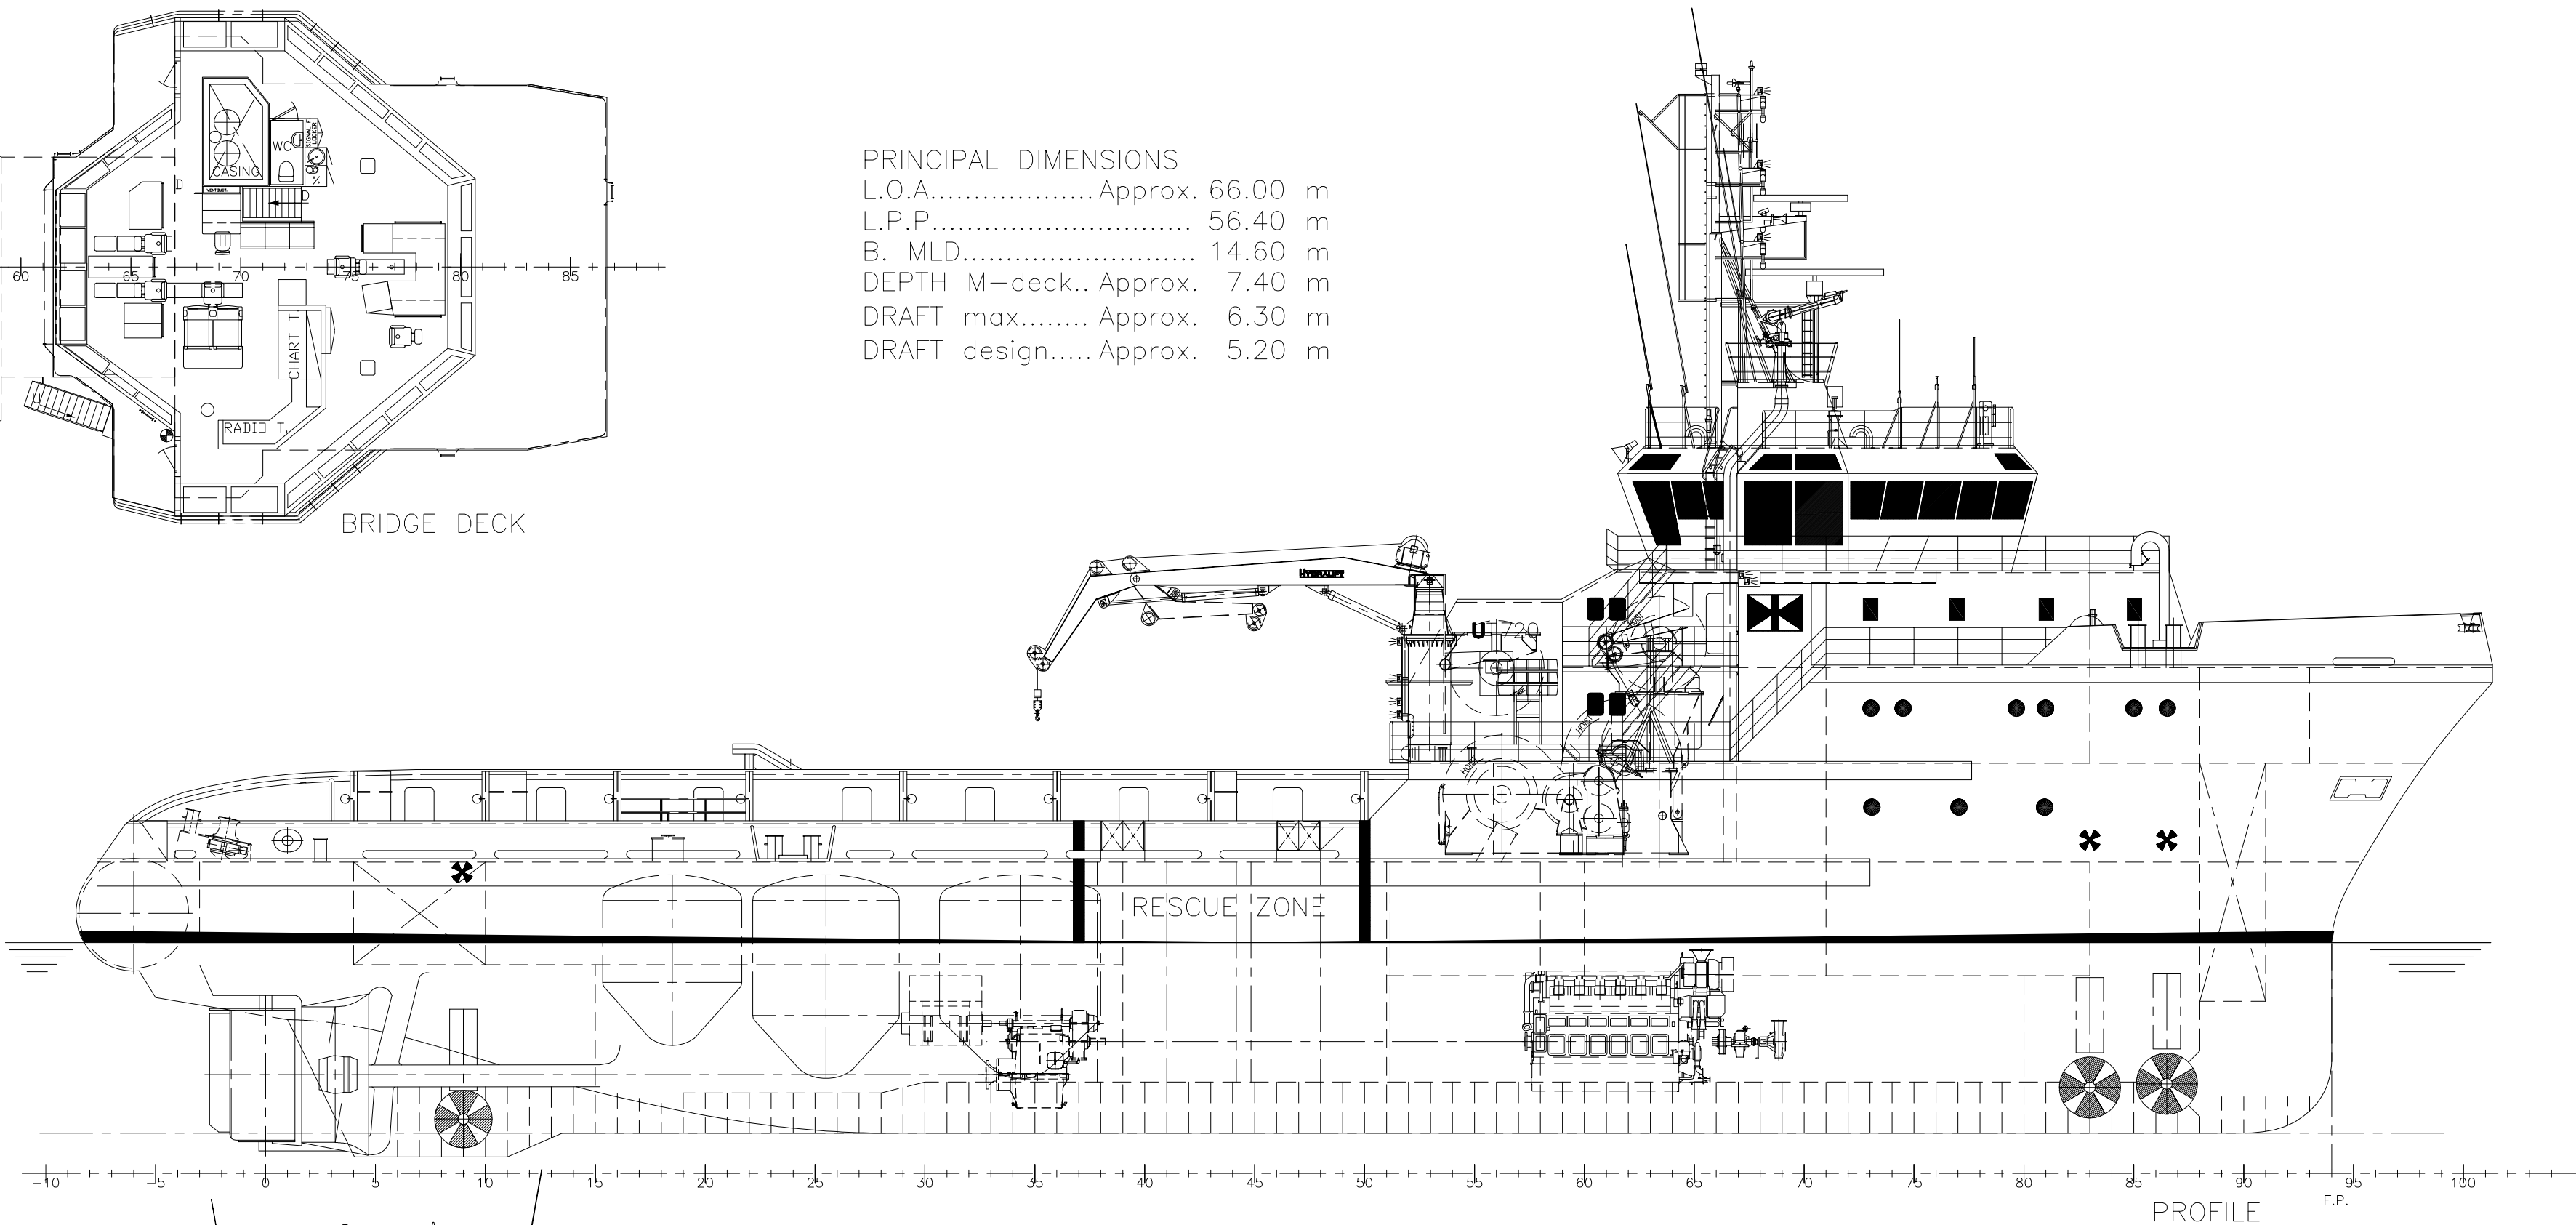


PROFILE

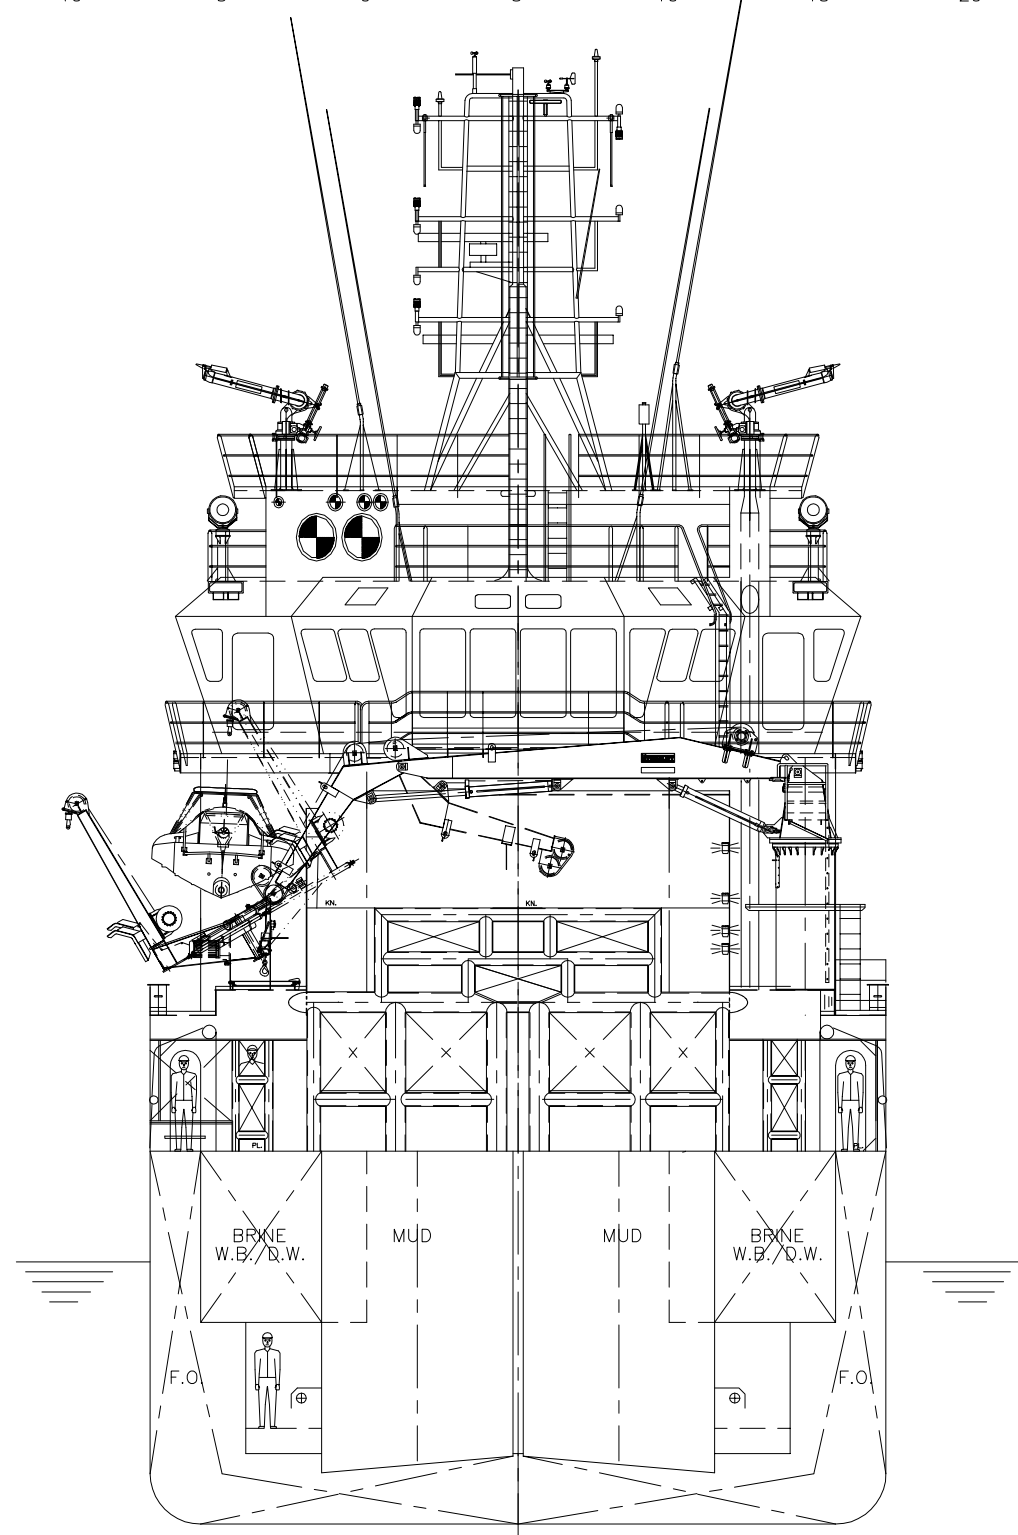


SEEN FROM AFT.

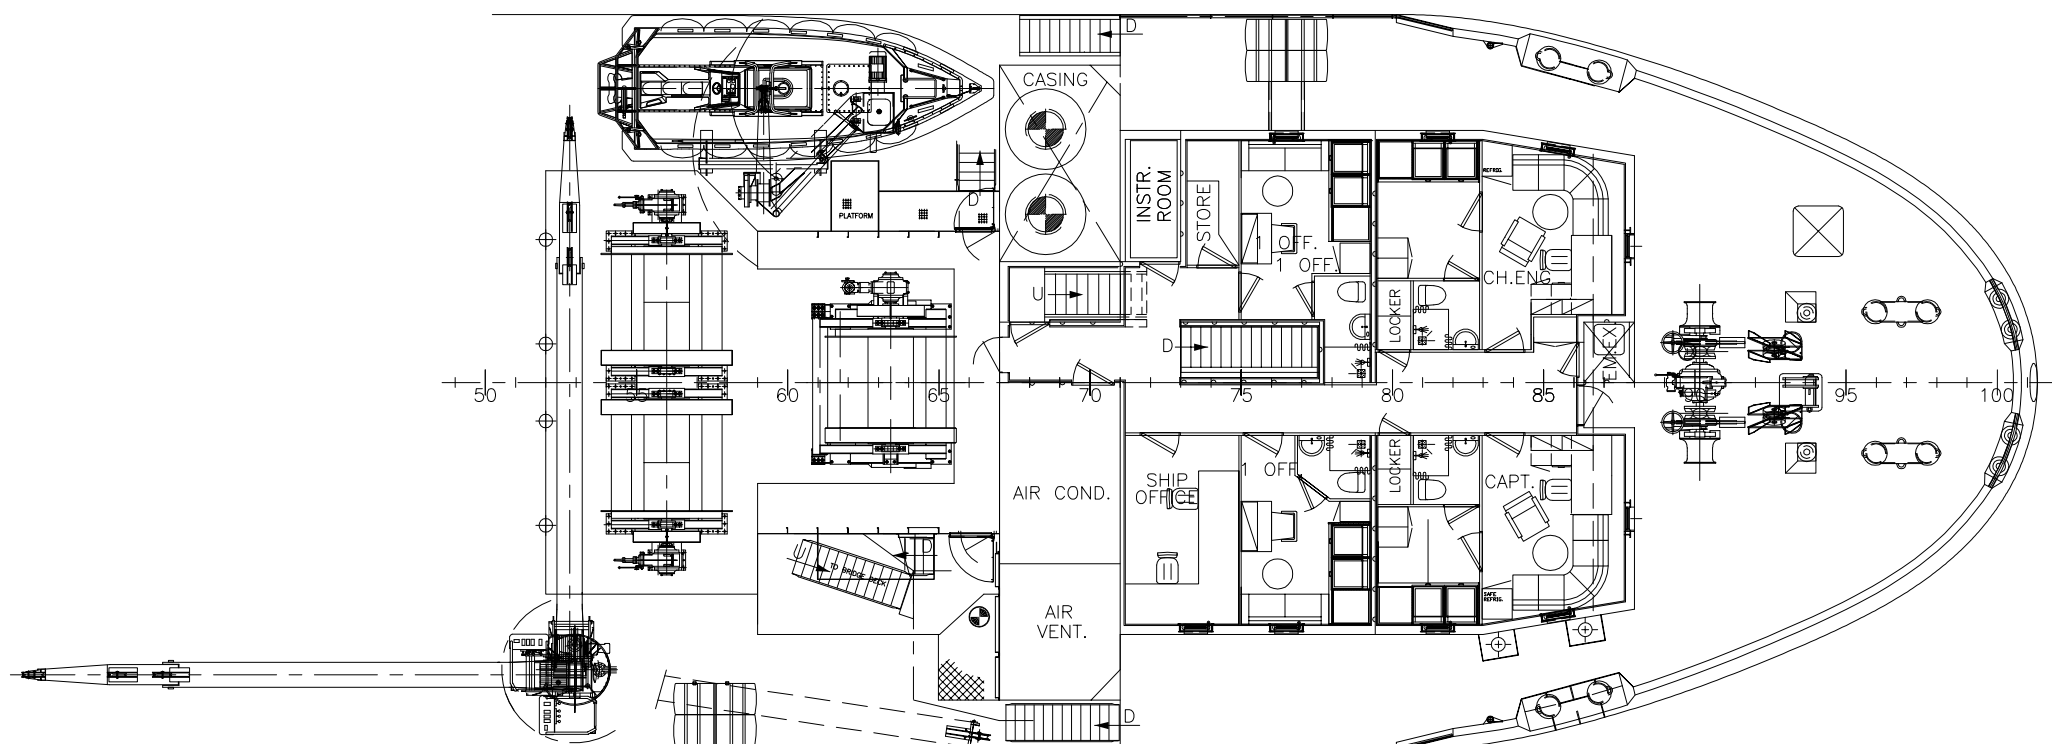


B-DECK

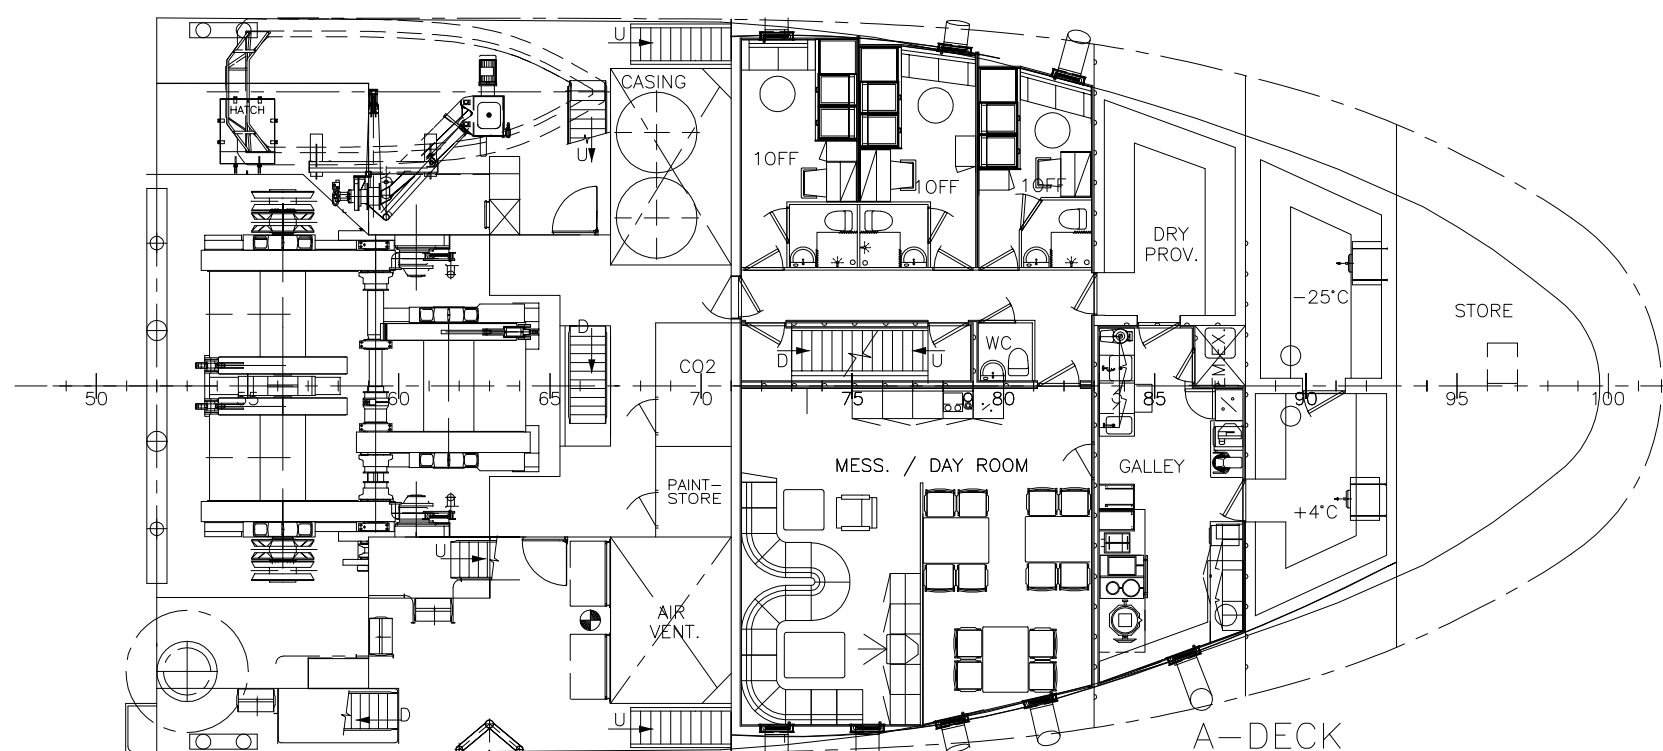


A-DECK

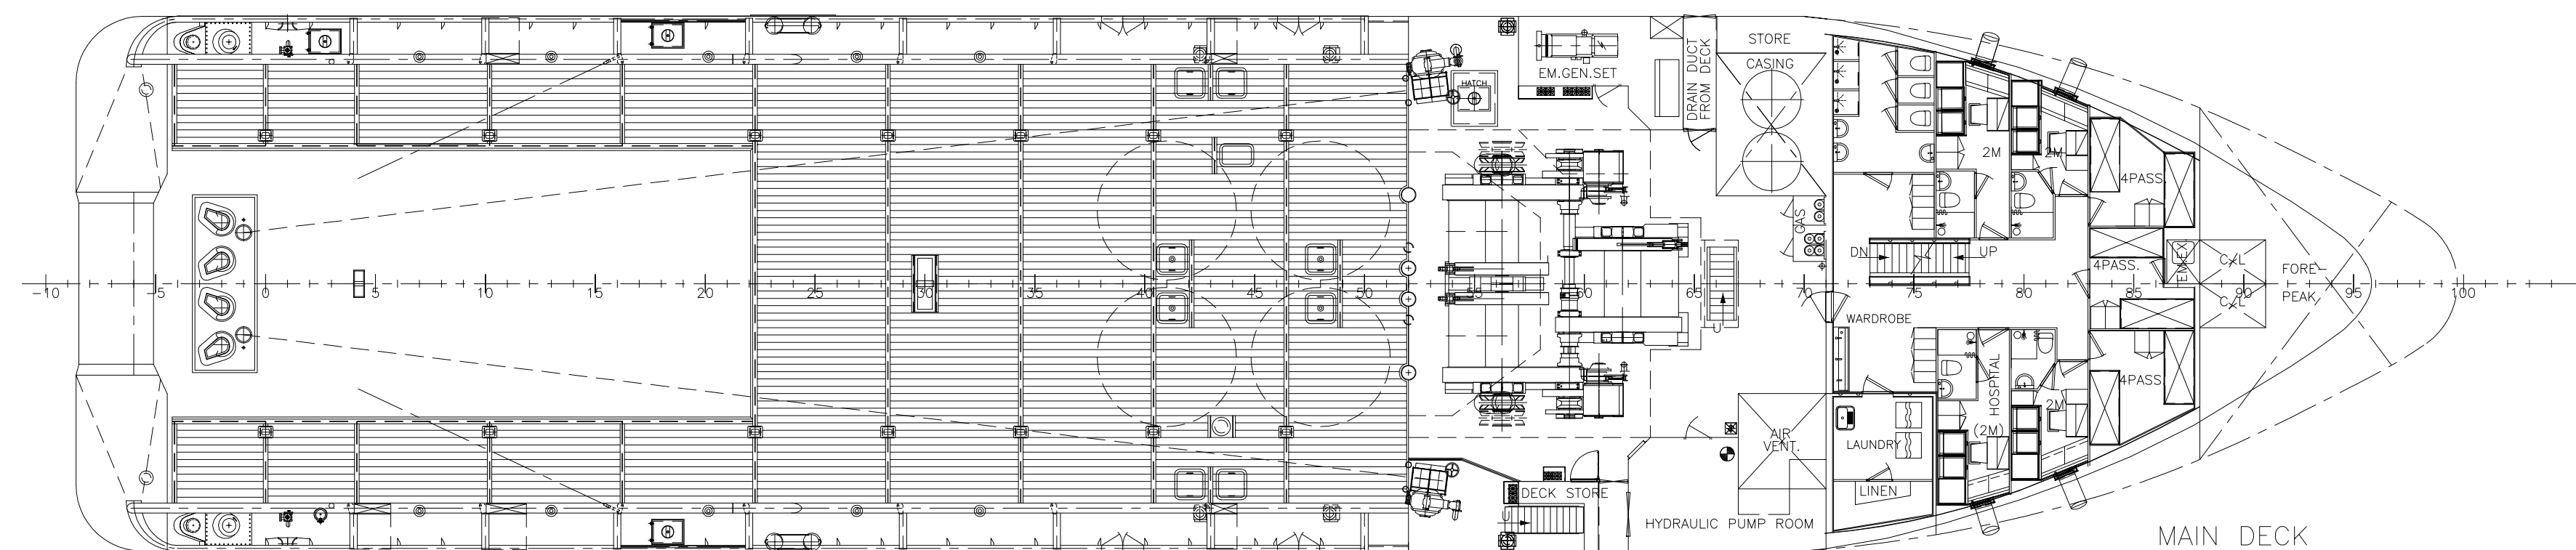

MAIN DECK

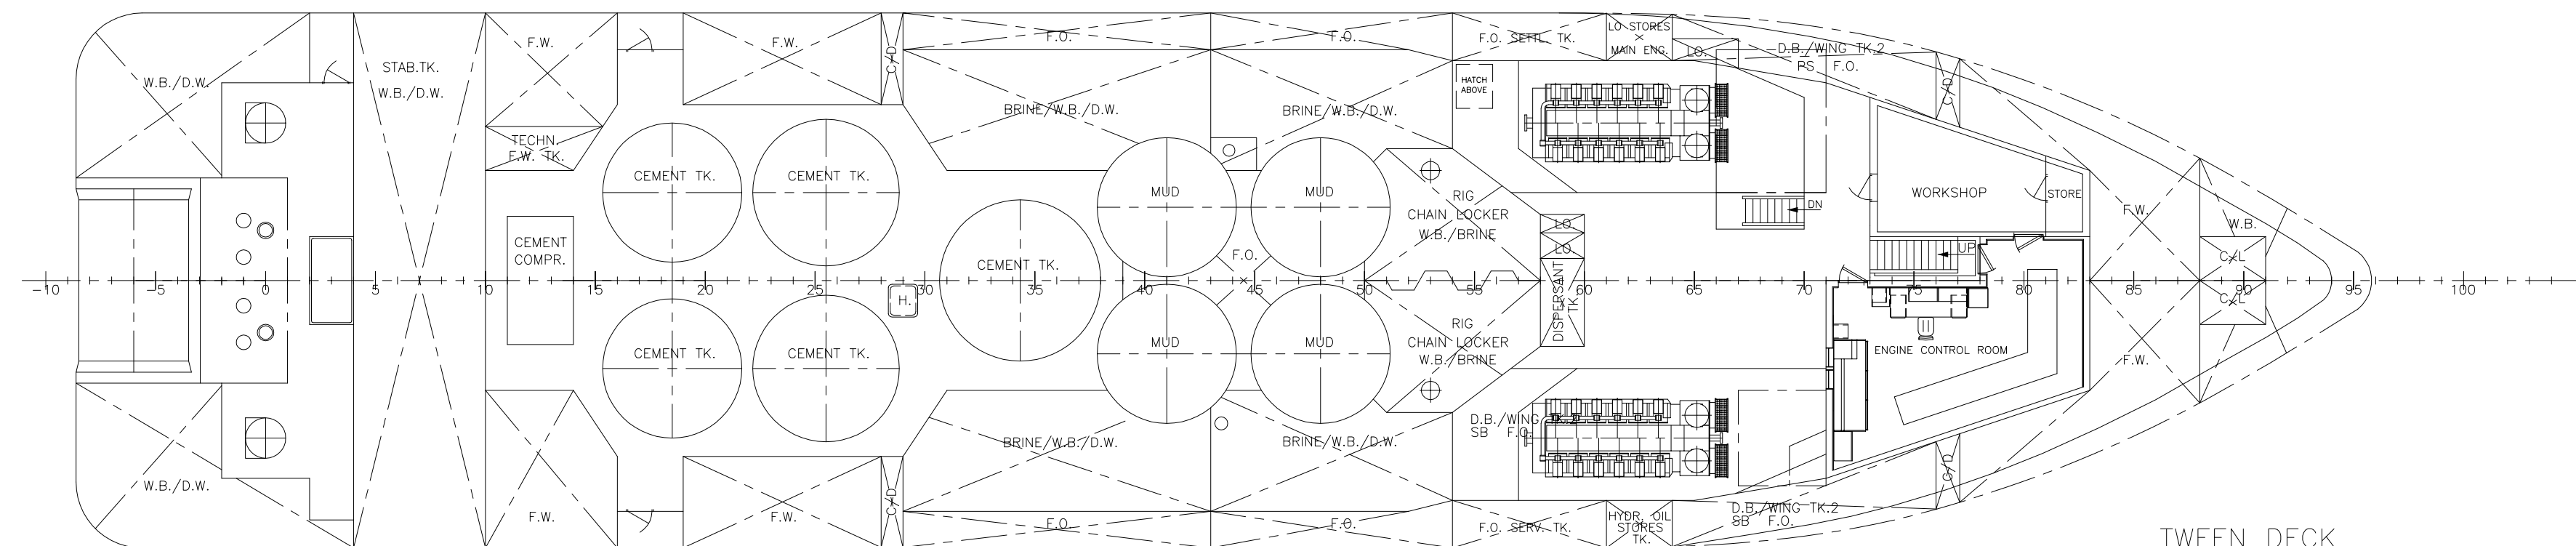

TWEEN DECK

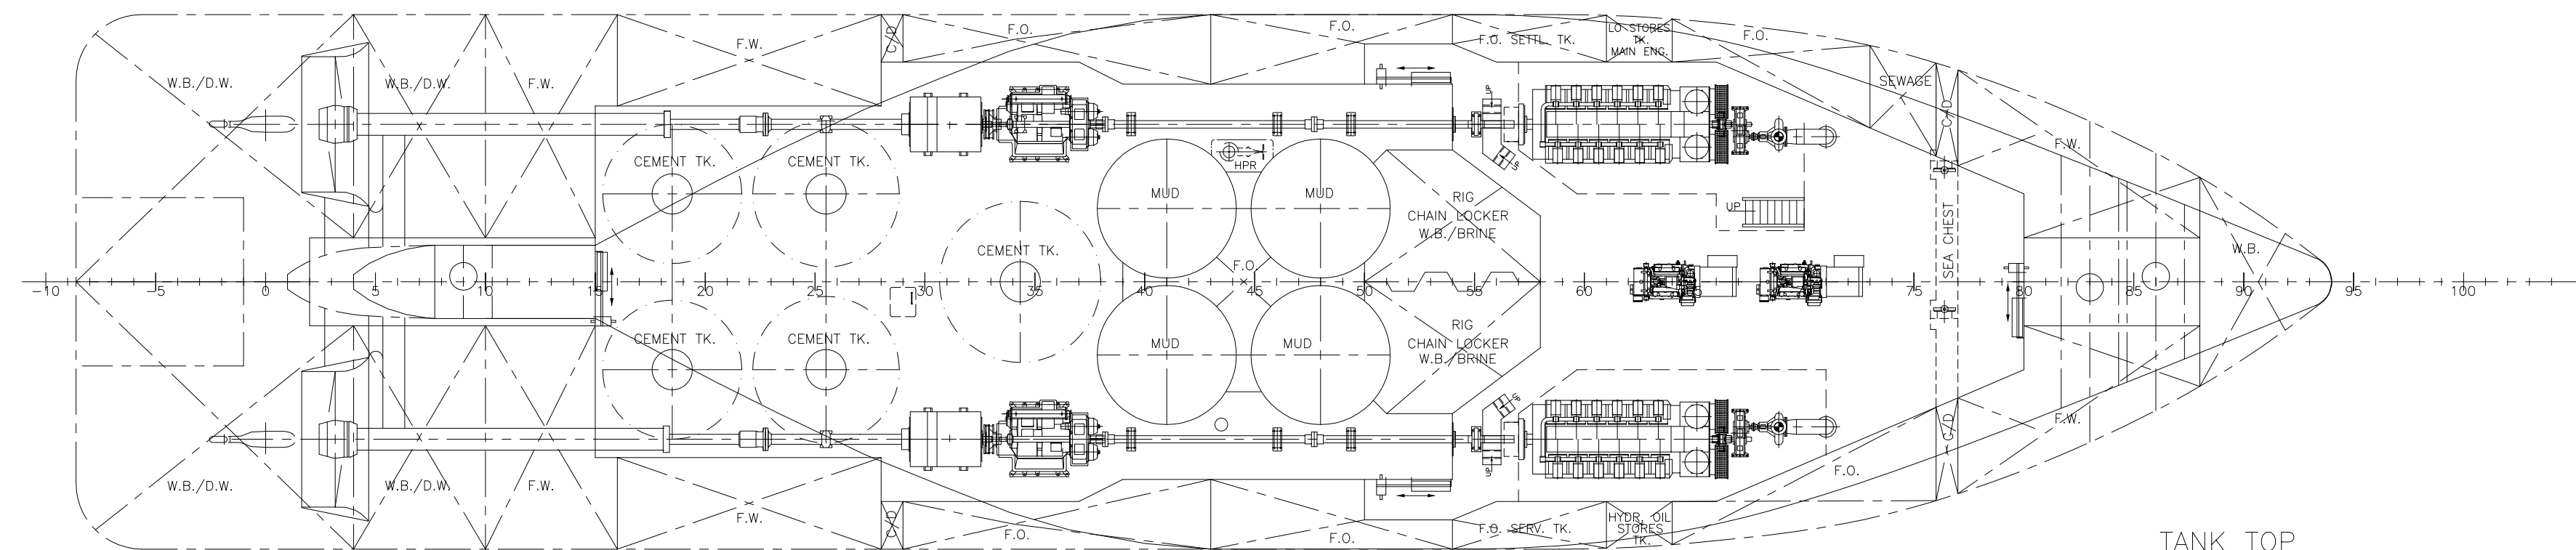

TANK TOP

This drawing (Specification) is the property of USTEN INDUSTRIER AS, and must not be copied or the contents thereof disclosed without the written consent of USTEN INDUSTRIER AS. If this drawing is used for a third party, it must not be used for any other purpose than the one for which it was originally prepared. The drawing is intended for use as a reference only. USTEN INDUSTRIER AS, NORWAY.

USTEN INDUSTRIER AS
Norway

GENERAL ARRANGEMENT

Scale: 1:100

Project No: 95/7152

Drawing No: P-0-3346

Sheet No: S-04464 B

AS BUILT

DATE: 17.04.97

BY: J. K. H. B.

REVISION

NO. 1

DATE: 02.01.97

BY: J. K. H. B.

REVISION

NO. 2

DATE: 02.01.97

BY: J. K. H. B.

REVISION

NO. 3

DATE: 02.01.97

BY: J. K. H. B.

REVISION

NO. 4

DATE: 02.01.97

BY: J. K. H. B.

REVISION

NO. 5

DATE: 02.01.97

BY: J. K. H. B.

REVISION

NO. 6

DATE: 02.01.97

BY: J. K. H. B.

REVISION

NO. 7

DATE: 02.01.97

BY: J. K. H. B.

REVISION

NO. 8

DATE: 02.01.97

BY: J. K. H. B.

REVISION

NO. 9

DATE: 02.01.97

BY: J. K. H. B.

REVISION

NO. 10

DATE: 02.01.97

BY: J. K. H. B.

REVISION

NO. 11

DATE: 02.01.97

BY: J. K. H. B.

REVISION

NO. 12

DATE: 02.01.97

BY: J. K. H. B.

REVISION

NO. 13

DATE: 02.01.97

BY: J. K. H. B.

REVISION

NO. 14

DATE: 02.01.97

BY: J. K. H. B.

REVISION

NO. 15

DATE: 02.01.97

BY: J. K. H. B.

REVISION

NO. 16

DATE: 02.01.97

BY: J. K. H. B.

REVISION

NO. 17

DATE: 02.01.97

BY: J. K. H. B.

REVISION

NO. 18

DATE: 02.01.97

BY: J. K. H. B.

REVISION

NO. 19

DATE: 02.01.97

BY: J. K. H. B.

REVISION

NO. 20

DATE: 02.01.97

BY: J. K. H. B.

REVISION

NO. 21

DATE: 02.01.97

